


Project Customer: **Mansourah Massarah Gold Project
MA'ADEN GOLD AND BASE METALS
(MA'ADEN)**

Title: **DETAIL DRAWING
LOW PRESSURE AIR
RCC DETAILS OF FOUNDATION**

Document Number: **MD-216-39AD-EG-CV-DED-1464**
Revision: **D01**
Revision Date: **16.05.2023**
Status: **AS BUILT**

Outotec Document Number:	900707	GAU01	AG10	CTB17	39502	OU100704675	5
L&T Document Number:	O19045	450	C	D	24446	001	5

REVISION HISTORY						
Rev	Date	Revision Text	Prepared By	Reviewed By	Approved By	Employer
A01	18.02.2021	ISSUED FOR REVIEW	SYA	SOR	SJM	
C01	17.03.2021	ISSUED FOR CONSTRUCTION	SYA	SOR	SJM	
C02	16.03.2022	ISSUED FOR CONSTRUCTION	AMJ	AVG	SJM	
C03	07.04.2022	ISSUED FOR CONSTRUCTION	AMJ	AVG	SJM	
C04	19.04.2022	ISSUED FOR CONSTRUCTION	AMJ	AVG	SJM	
D01	16.05.2023	AS BUILT	AMJ	AVG	SJM	

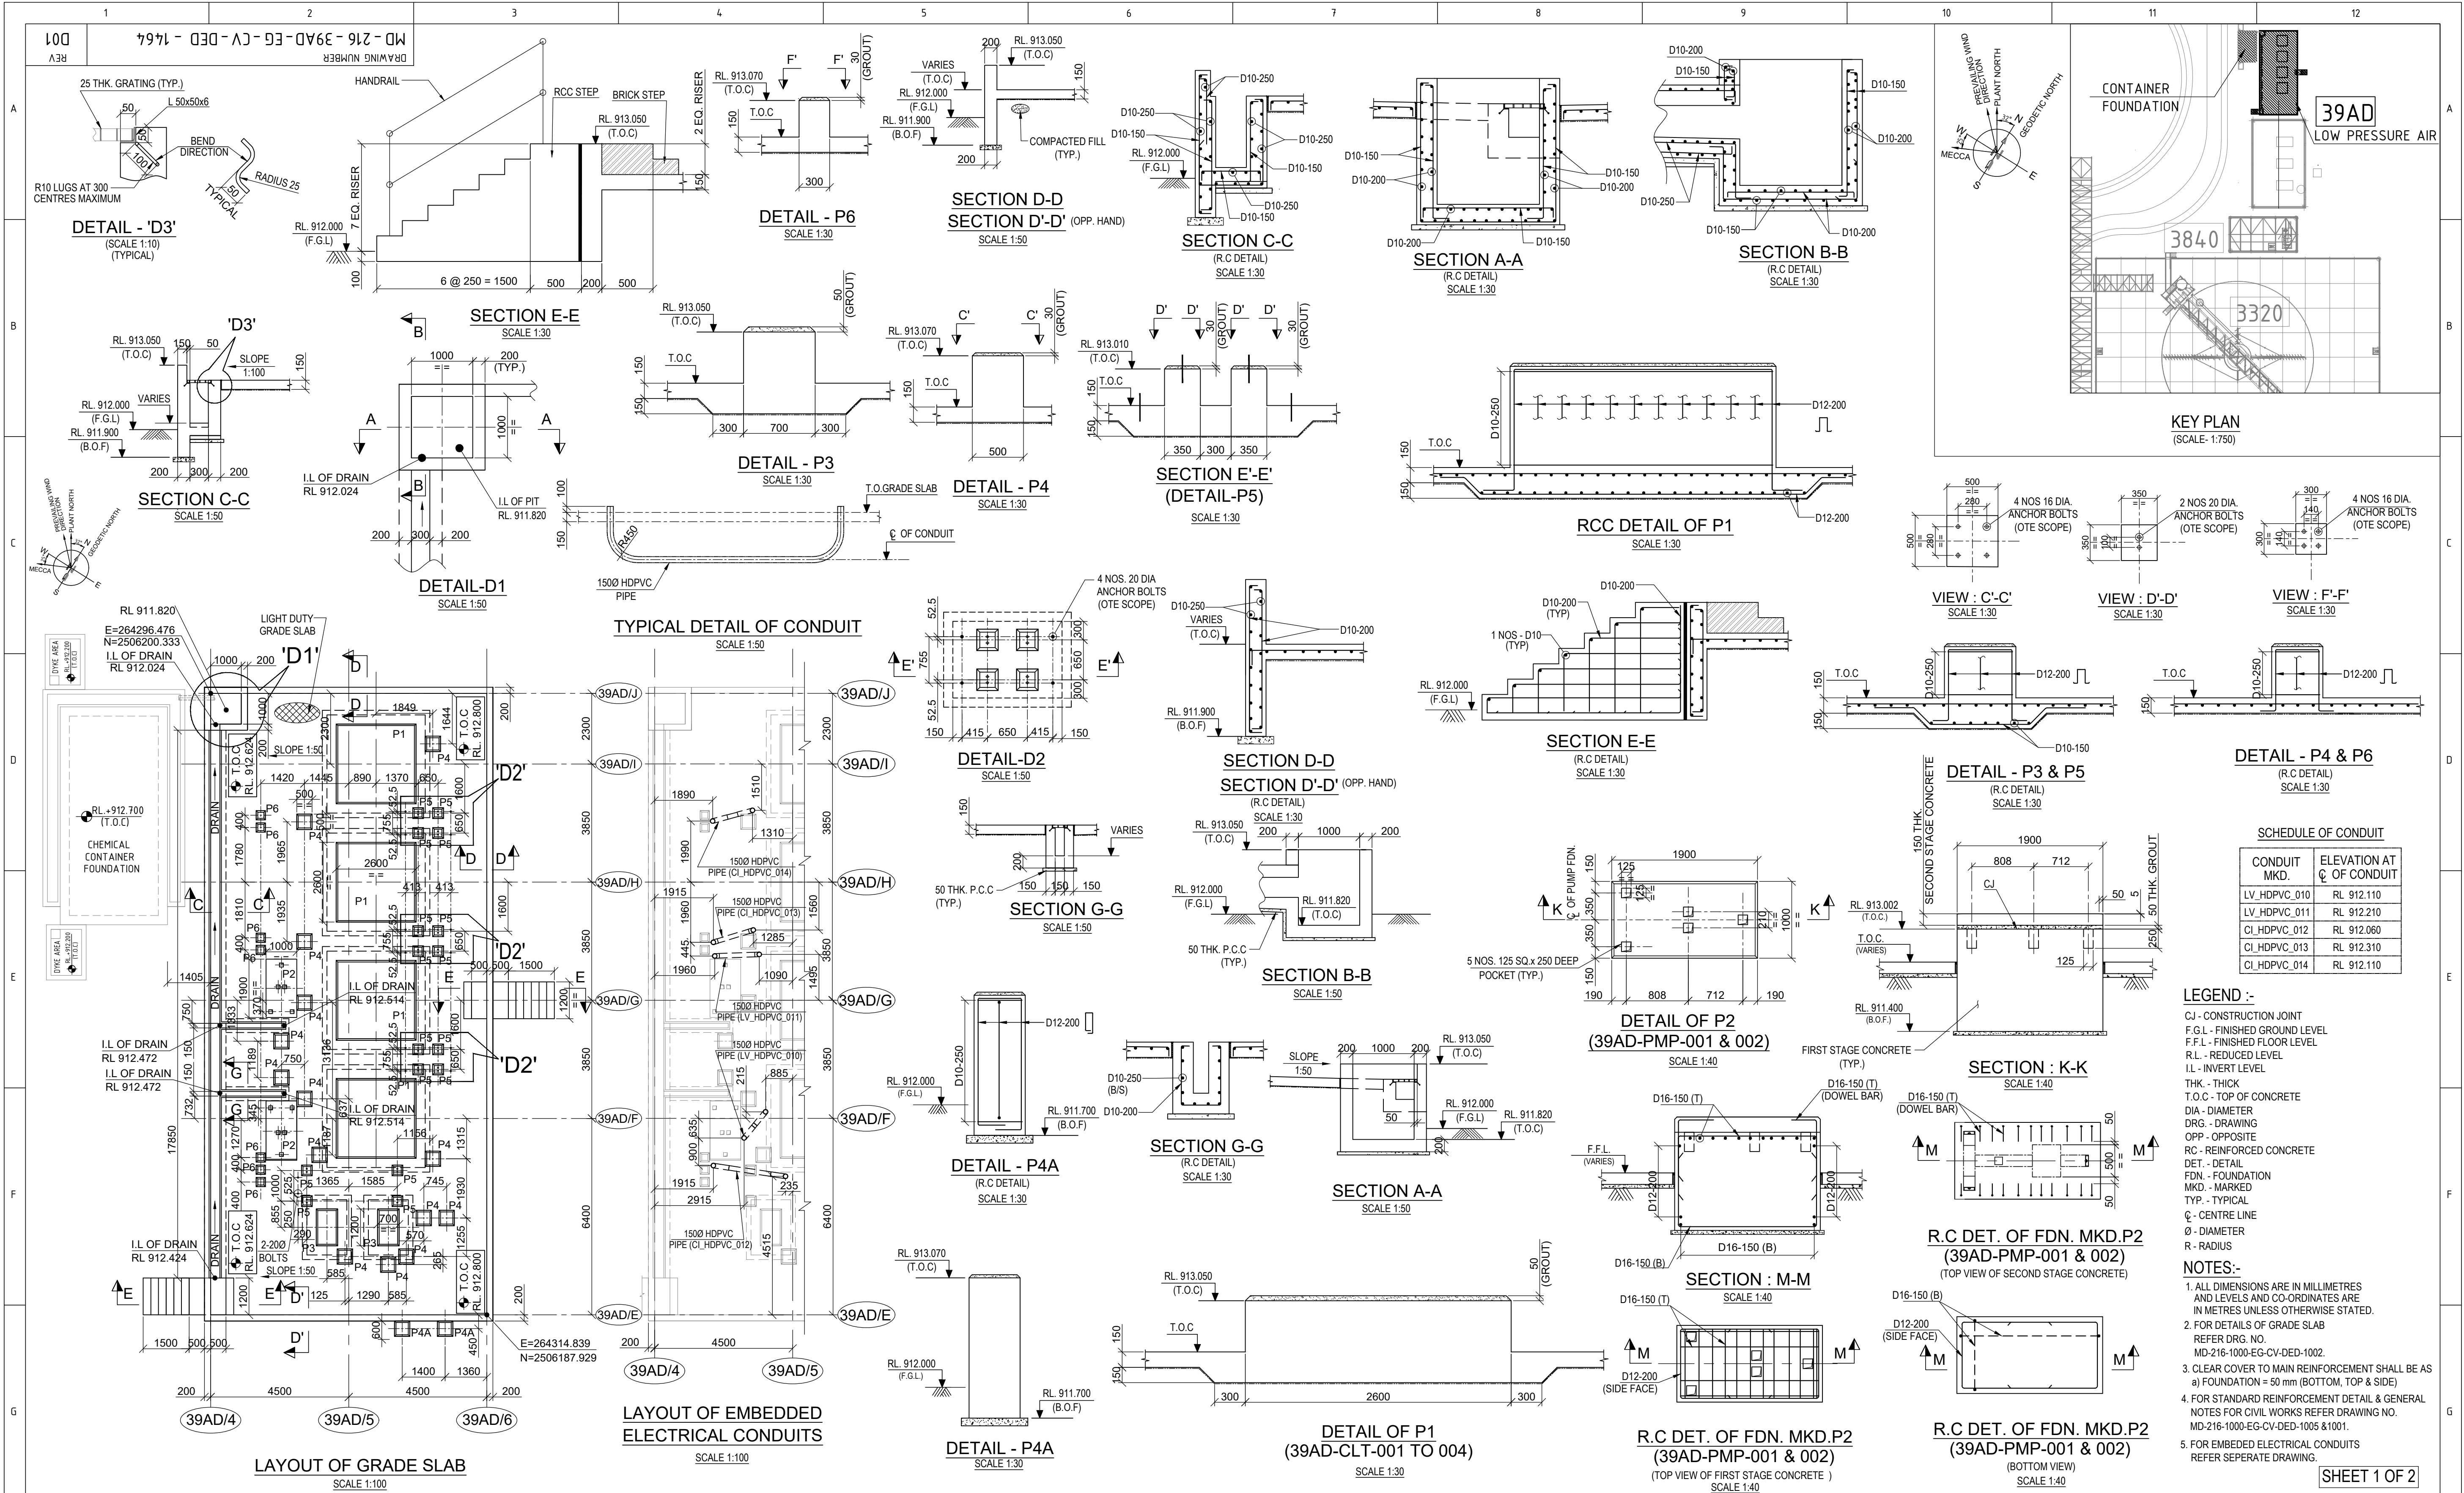

--	--	



This drawing is the property of LARSEN & TOUBRO and must not be passed on to any person or body not authorized by us to receive it nor be copied or otherwise made use of in full or in part by such person or body without our prior permission in writing.

The content of these documents are the sole property of Outotec Oyj. Any rights not expressly granted herein are reserved. Reproduction, transfer or distribution of part or all of the contents in any form without prior written permission of Outotec is prohibited.

This document and the information contained herein is Ma'aden proprietary know-how. This document or any part thereof should not be reproduced, stored in a retrieval system or transmitted by any means, electronic or otherwise, or divulged without prior written permission of Ma'aden.

LARSEN & TOUBRO DRAWING NUMBER				REVISION	
019045_450_C_D_24446_001				5	
OUTOTEC DRAWING NUMBER				DOCUMENT ID	
900707_GAU01_AG10_CTB17_39502				OU100704675	
				REVISION	
				5	
DRAWN		SYA	16/02/2021	MANSOURAH - MASSARAH GOLD PROJECT DETAIL DRAWING LOW PRESSURE AIR RCC DETAILS OF FOUNDATION	
CHECKED		SJM	17/02/2021		
ENGINEER		SOR	16/02/2021		
APPROVED		AG	18/02/2021		
EMPLOYER				DRAWING NUMBER	
SCALE		1:50, 1:25, 1:20			
		A1	MD - 216 - 39AD- EG - CV - DED - 1464		REV
					D01

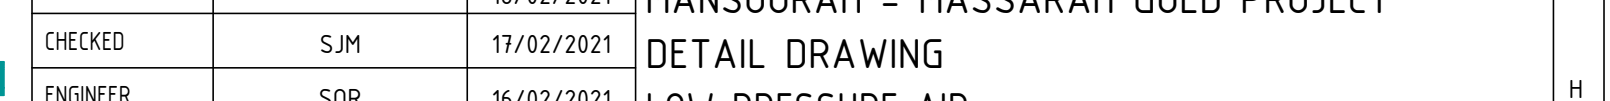

This document and the information contained herein is Ma'aden proprietary know-how. This document or any part thereof should not be reproduced, stored in a retrieval system or transmitted by any means, electronic or otherwise, or divulged without prior written permission of Ma'aden.

