




DRAWING NUMBER: MD-216-3110-EG-CV-DED-1003 | REV: D01

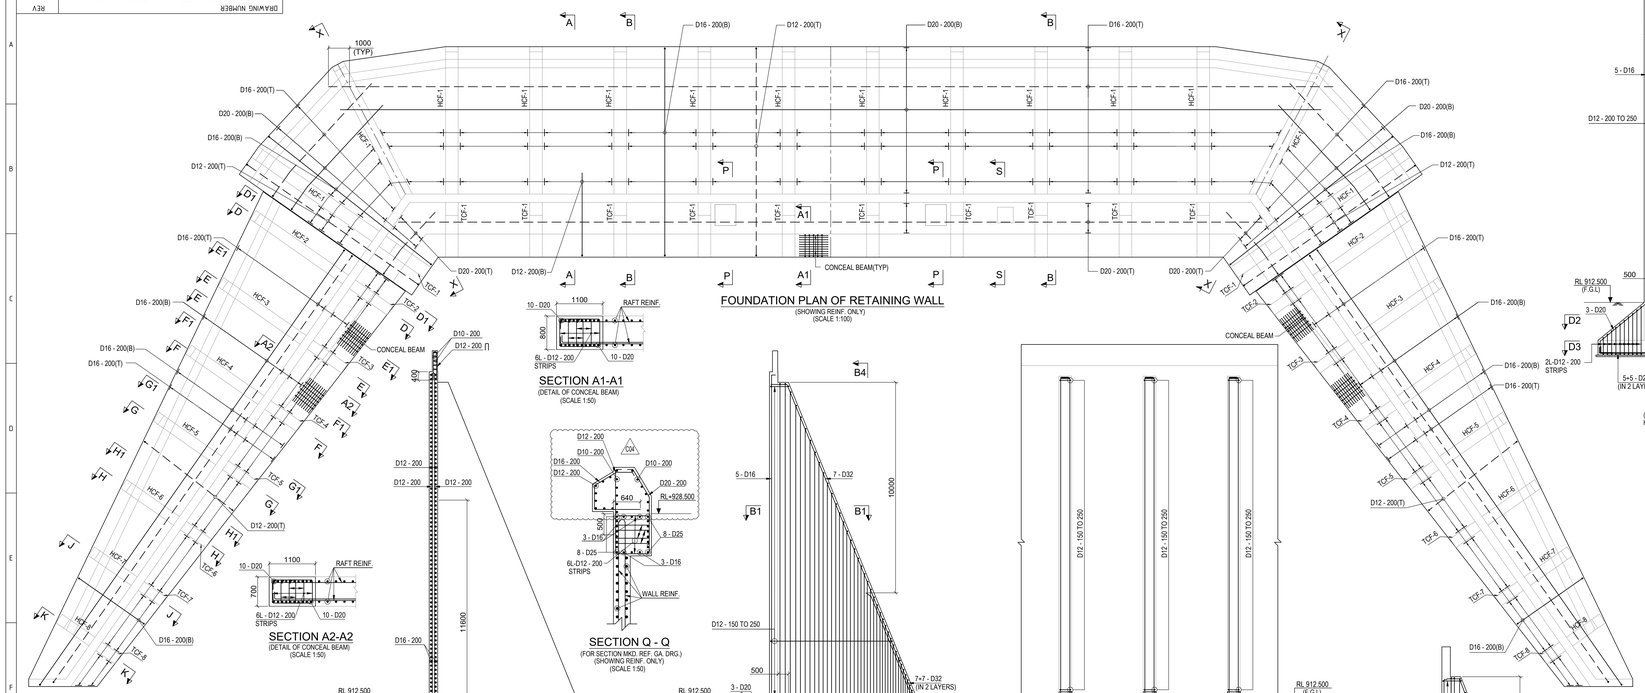


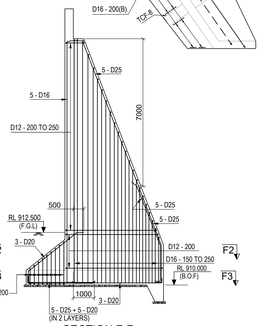


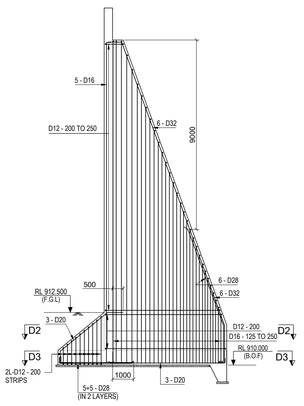


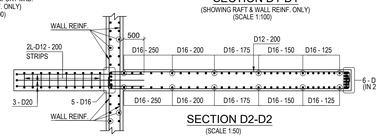


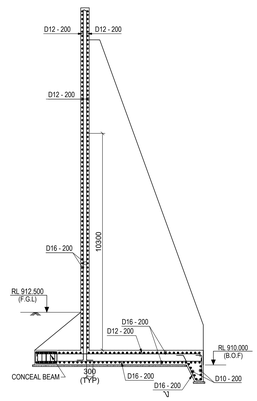


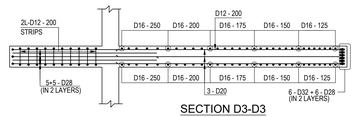


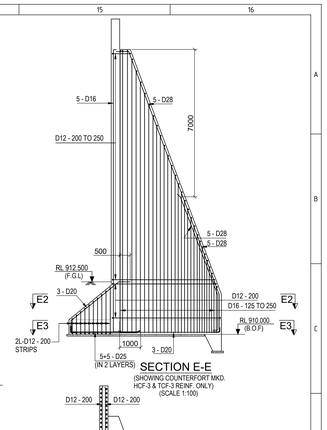


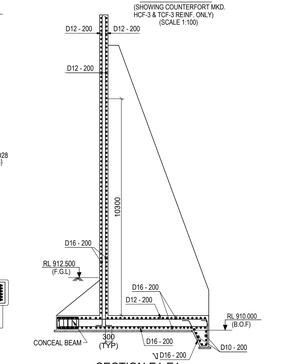


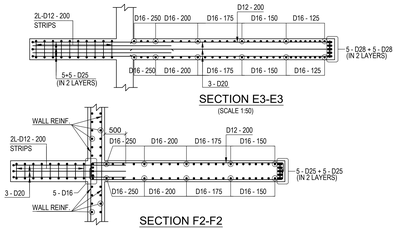


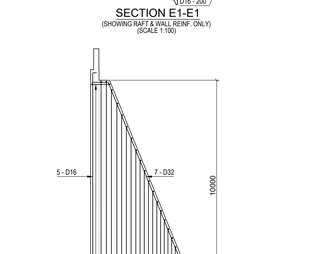


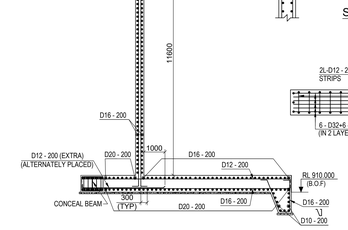


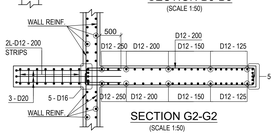


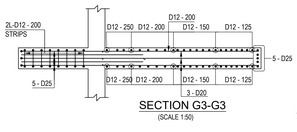


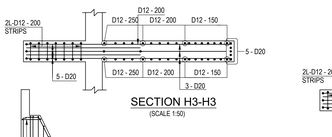


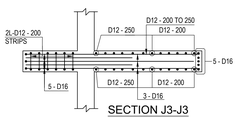


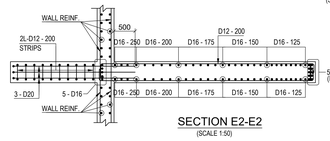


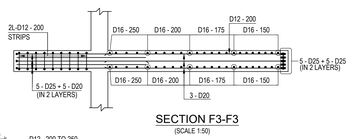


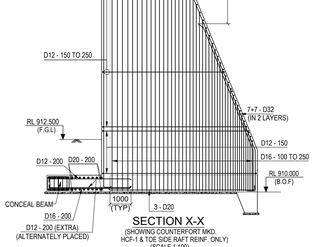


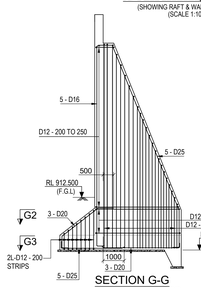


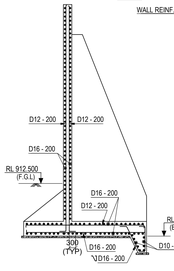


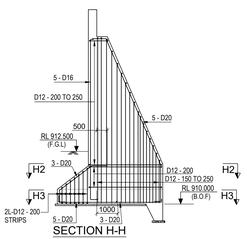


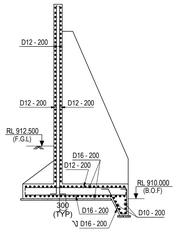


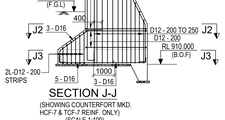


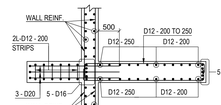

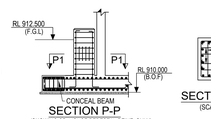

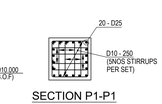

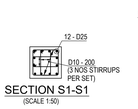

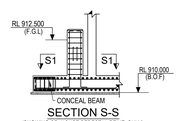

LEGEND:-

T.O.C	TOP OF CONCRETE
B.O.F	BOTTOM OF FOUNDATION
F.G.L	FINISHED GROUND LEVEL
REINF.	REINFORCEMENT

NOTES:-

1. ALL DIMENSIONS ARE IN MILLIMETERS AND LEVELS ARE IN METERS UNLESS OTHERWISE STATED.
2. GRADE OF CONCRETE SHALL BE C35
3. GRADE OF REINFORCEMENT SHALL BE DEFORMED BAR ASTM A615-GRADE 60 (fy=420 MPa)
4. CLEAR COVER TO MAIN REINFORCEMENT SHALL BE AS FOLLOWS:
 a) RAFT : 75 mm. (BOTTOM & SIDE)
 b) RAFT : 50 mm. (TOP)
 c) WALL : 50 mm.
 d) COUNTERFORT : 50 mm.
5. FOR GA DRAWING REF. DRG. NO. MD - 216 - 3110 - EG - CV - GAD - 1003.
6. FOR LAP SPLICE LENGTH OF DEFORMED BARS REF. DRG. NO. MD - 216 - 1000 - EG - CV - DED - 1001.
7. FOR GENERAL NOTES OF CIVIL WORKS REF. DRG. NO. MD - 216 - 1000 - EG - CV - DED - 1001.
8. FOR STANDARD REINFORCEMENT DETAILS REF. DRG. NO. MD-216-1000-EG-CV-DED-1005.

DOCUMENT NUMBER	REFERENCE DOCUMENTS	REV	DATE	REVISION DESCRIPTION	DRN	CHK	ENG	APP	EMP
		D01	10/03/2023	AS-BUILT	SBH	BDA	SUE	AG	
		C04	08/12/2020	ISSUED FOR CONSTRUCTION & REVISED AS MARKED △24	SBH	BDA	SUE	AG	
		C03	16/05/2020	ISSUED FOR CONSTRUCTION.	SBH	BDA	SUE	AG	
		C02	20/03/2020	ISSUED FOR CONSTRUCTION.	SBH	BDA	SUE	AG	
		C01	24/01/2020	ISSUED FOR CONSTRUCTION.	SBH	BDA	SUE	AG	
		A02	02/01/2020	REVISED AS PER EMPLOYER COMMENTS ON 26/12/2019	SBH	BDA	SUE	AG	
		A01	05/12/2019	ISSUED FOR REFERENCE	SBH	BDA	SUE	AG	

RESERVED FOR VENDOR LOGO AND DRAWING NUMBER

LARSEN & TOUBRO

This drawing is the property of LARSEN & TOUBRO and must not be passed on to any person or body not authorised by us to receive it nor be copied or otherwise made use either in full or in part by such person or body without our prior permission in writing.

Outotec

The content of these documents are the sole property of Outotec Oy. Any rights not expressly granted herein are reserved. Reproduction, transfer or distribution of part or all of the contents in any form without prior written permission of Outotec is prohibited.

MA'ADEN معادن Saudi Arabian Mining Company شركة المعادن العربية السعودية

This document and the information contained herein is Ma'aden proprietary know-how. This document or any part thereof should not be reproduced, stored in a retrieval system or transmitted by any means, electronic or otherwise, or divulged without prior written permission of Ma'aden.

LARSEN & TOUBRO DRAWING NUMBER	019045_100_C_D_24060_001
REVISION	6
OUTOTEC DRAWING NUMBER	900707__GAU01__ZC01__CTB17__31102
DOCUMENT ID	OU100666793
REVISION	6
DRAWN	SBH 02/12/2019
CHECKED	BDA 04/12/2019
ENGINEER	SUE 02/12/2019
APPROVED	AG 05/12/2019
EMPLOYER	
SCALE	1:100
PAPER SIZE	A0

MANSOURAH - MASSARAH GOLD PROJECT
DETAIL DRAWING
PRIMARY CRUSHING
ROM RETAINING WALL RC DETAILS

DRAWING NUMBER: MD-216-3110-EG-CV-DED-1003
REV: D01